

CIANBRO



Waterville - Winslow Ticonic Bridge Replacement

**TRAFFIC CONTROL
4.24.23 REVISION**

Table Of Contents

Sheet 1- Lane Designation Sheet- **Page 1**

Plan A- Upstream Bridge Pedestrian Detour- **Pages 2-3**

Plan B- Waterville Side Right Lane Closure- **Page 4**

Plan C-1- Waterville Side Left Lane Closure- **Page 5**

Plan C-2- Waterville Side Left Lane Closure with Lane Restriction Eastbound- **Page 6**

Plan D- Full Westbound Lane Closure- **Pages 7-8**

Plan E- Full Eastbound Lane Closure- **Pages 8-10**



Plan F- Full Bridge Closure- **Page 11**


Plan G- Pedestrian Detour- **Page 12**

Notes:

1. Traffic Control Setups are subject to change.
2. Traffic Control Setups may be field fit as necessary.
3. Always follow direction of signage and flaggers while transiting work zone.

Lane Designation

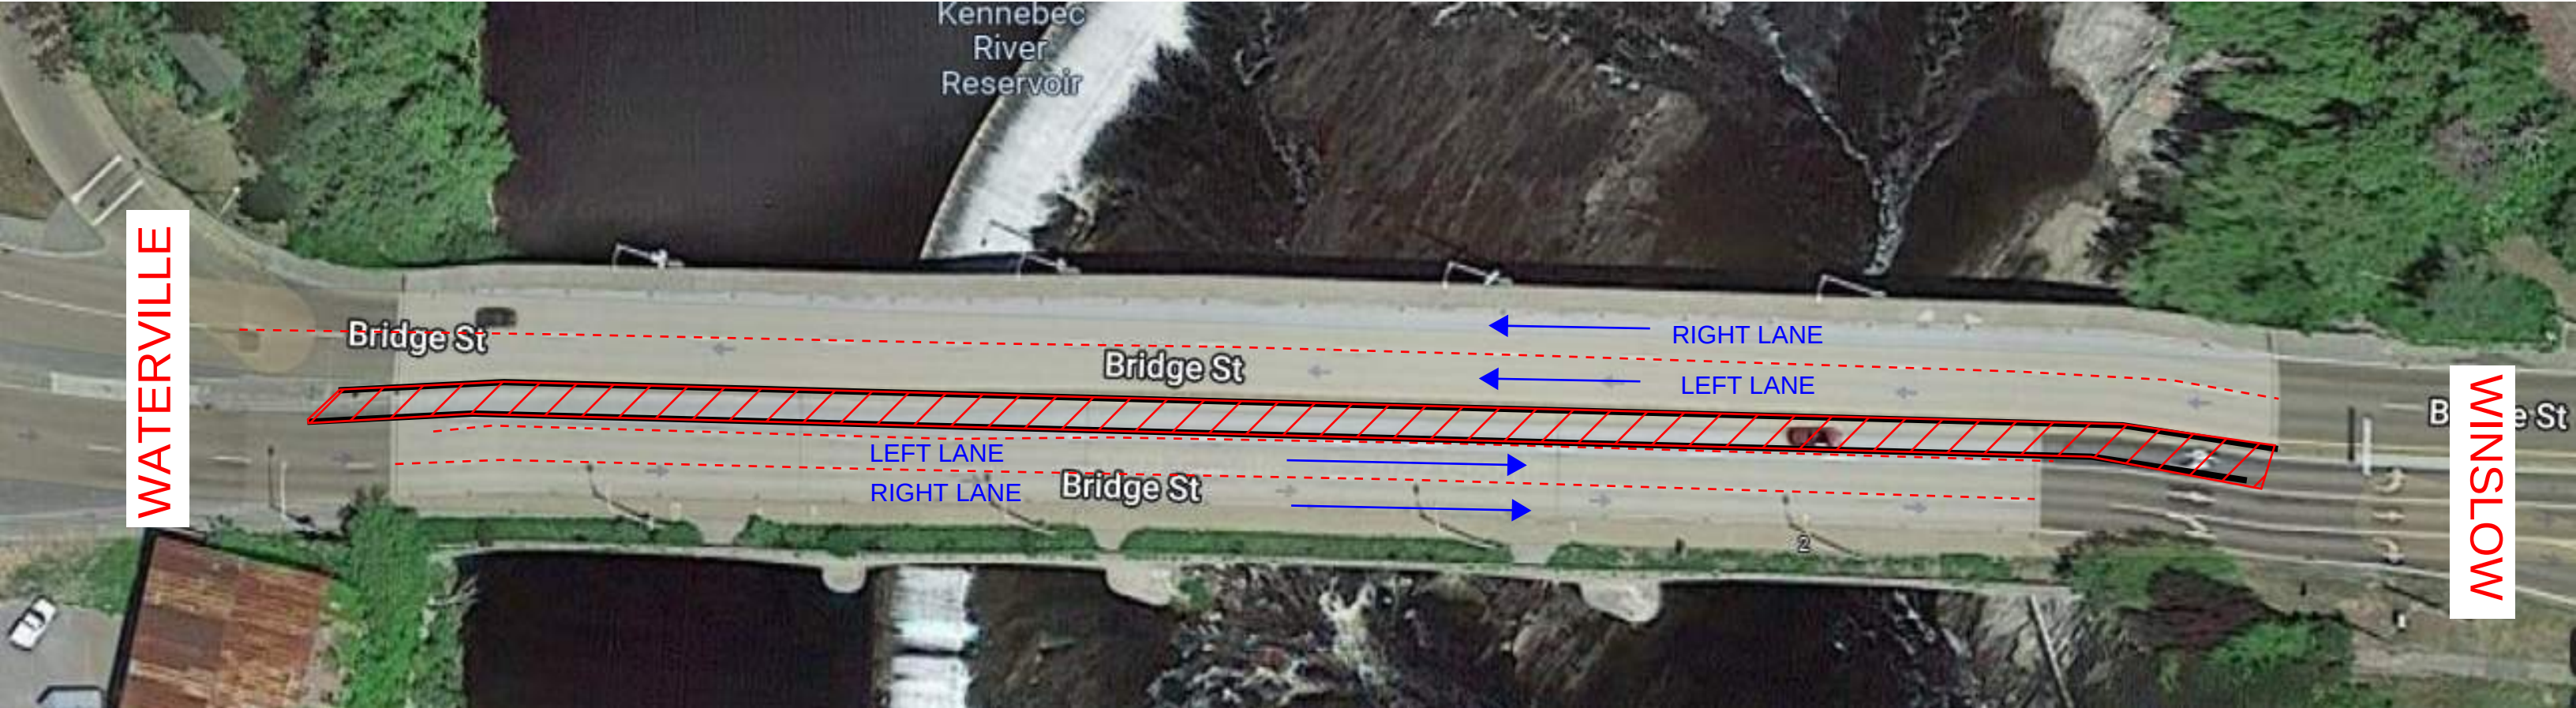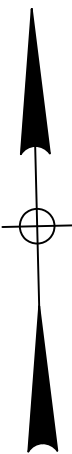

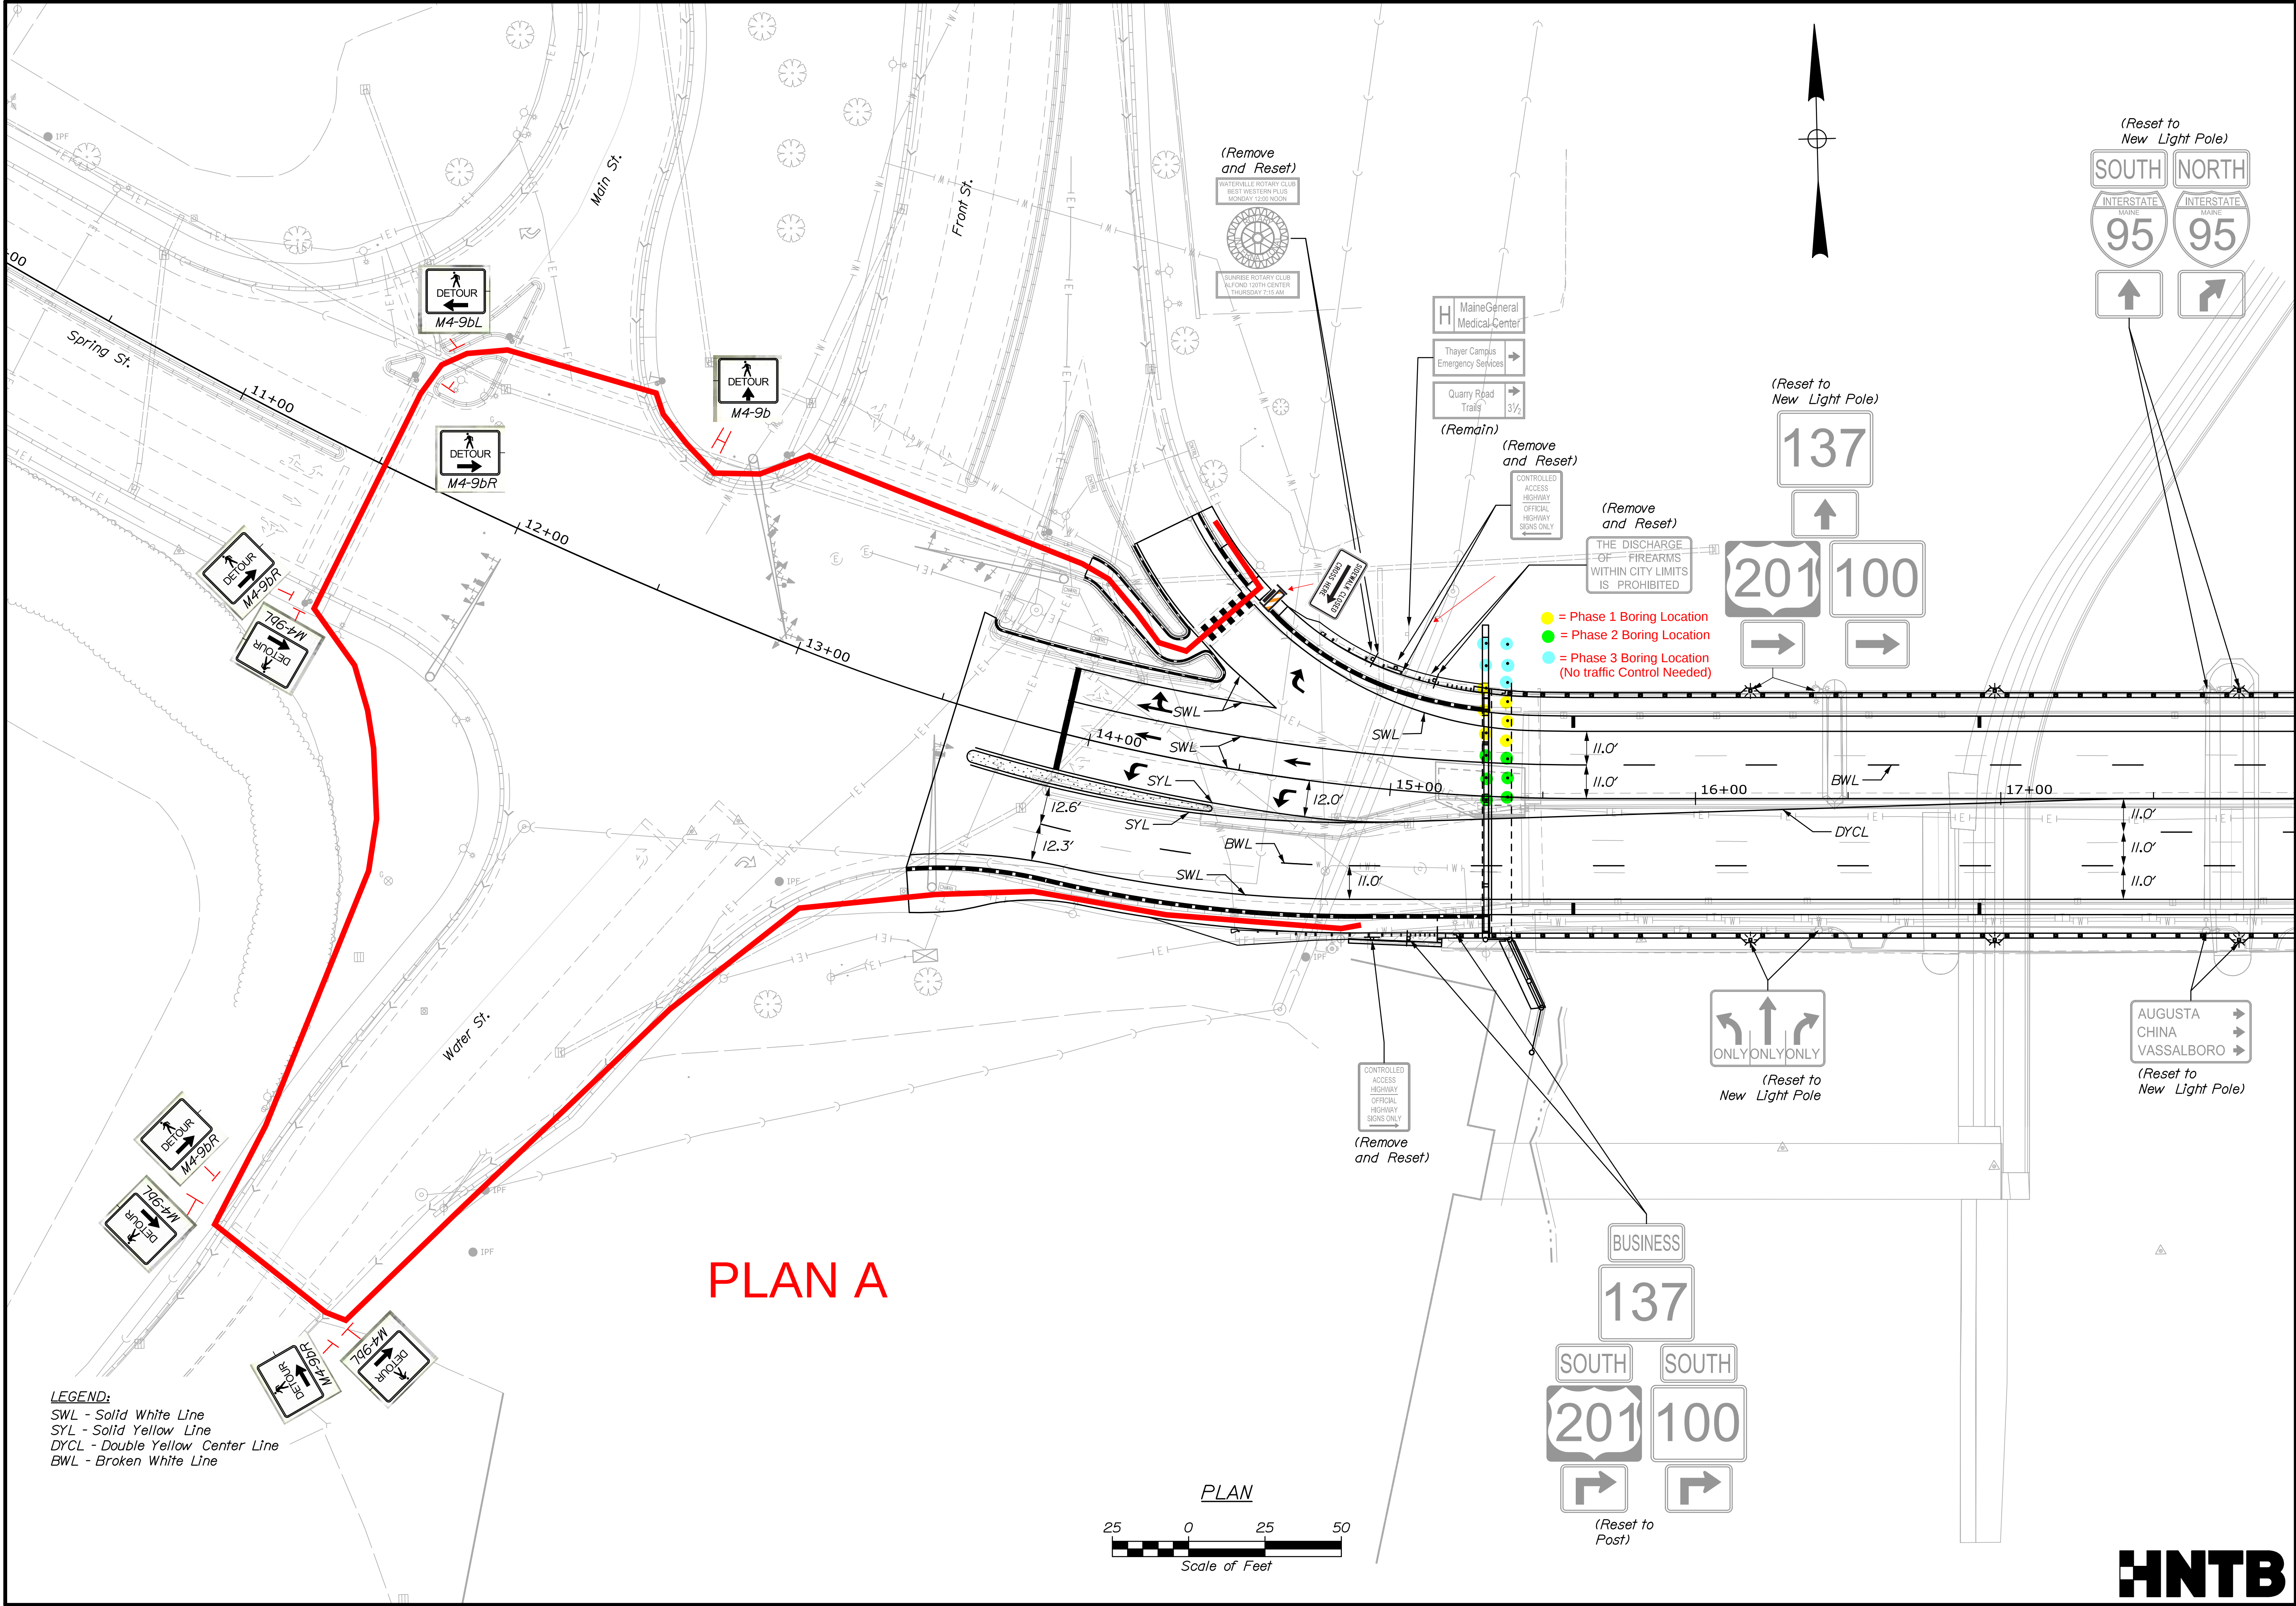

STATE OF MAINE DEPARTMENT OF TRANSPORTATION		2313800		WIN 023138.00		BRIDGE PLANS	
TICONIC BRIDGE KENNEBEC RIVER RESERVOIR WATERVILLE-WINSLOW		SIGNING & STRIPING PLAN 1		SHEET NUMBER 20 OF 111		DATE 6/20/22 SIGNATURE P.E. NUMBER DATE	
PROJ. MANAGER M. Parlin	BY C. Helmick R. Hart	CHECKED L. Driscoll	DESIGNED L. Driscoll	DESIGNED L. Driscoll	REVISIONS 1 2 3 4	FIELD CHANGES	

PLAN A

Notes:
1. All Advanced Warning Signs as shown in Standard detailed 652(12) are pre-installed.




PLAN B

Notes:
1. All Advanced Warning Signs as shown in Standard detailed 652(12) are pre-installed.




PLAN C-1

Notes:
1. All Advanced Warning Signs as shown in Standard detailed 652(12) are pre-installed.

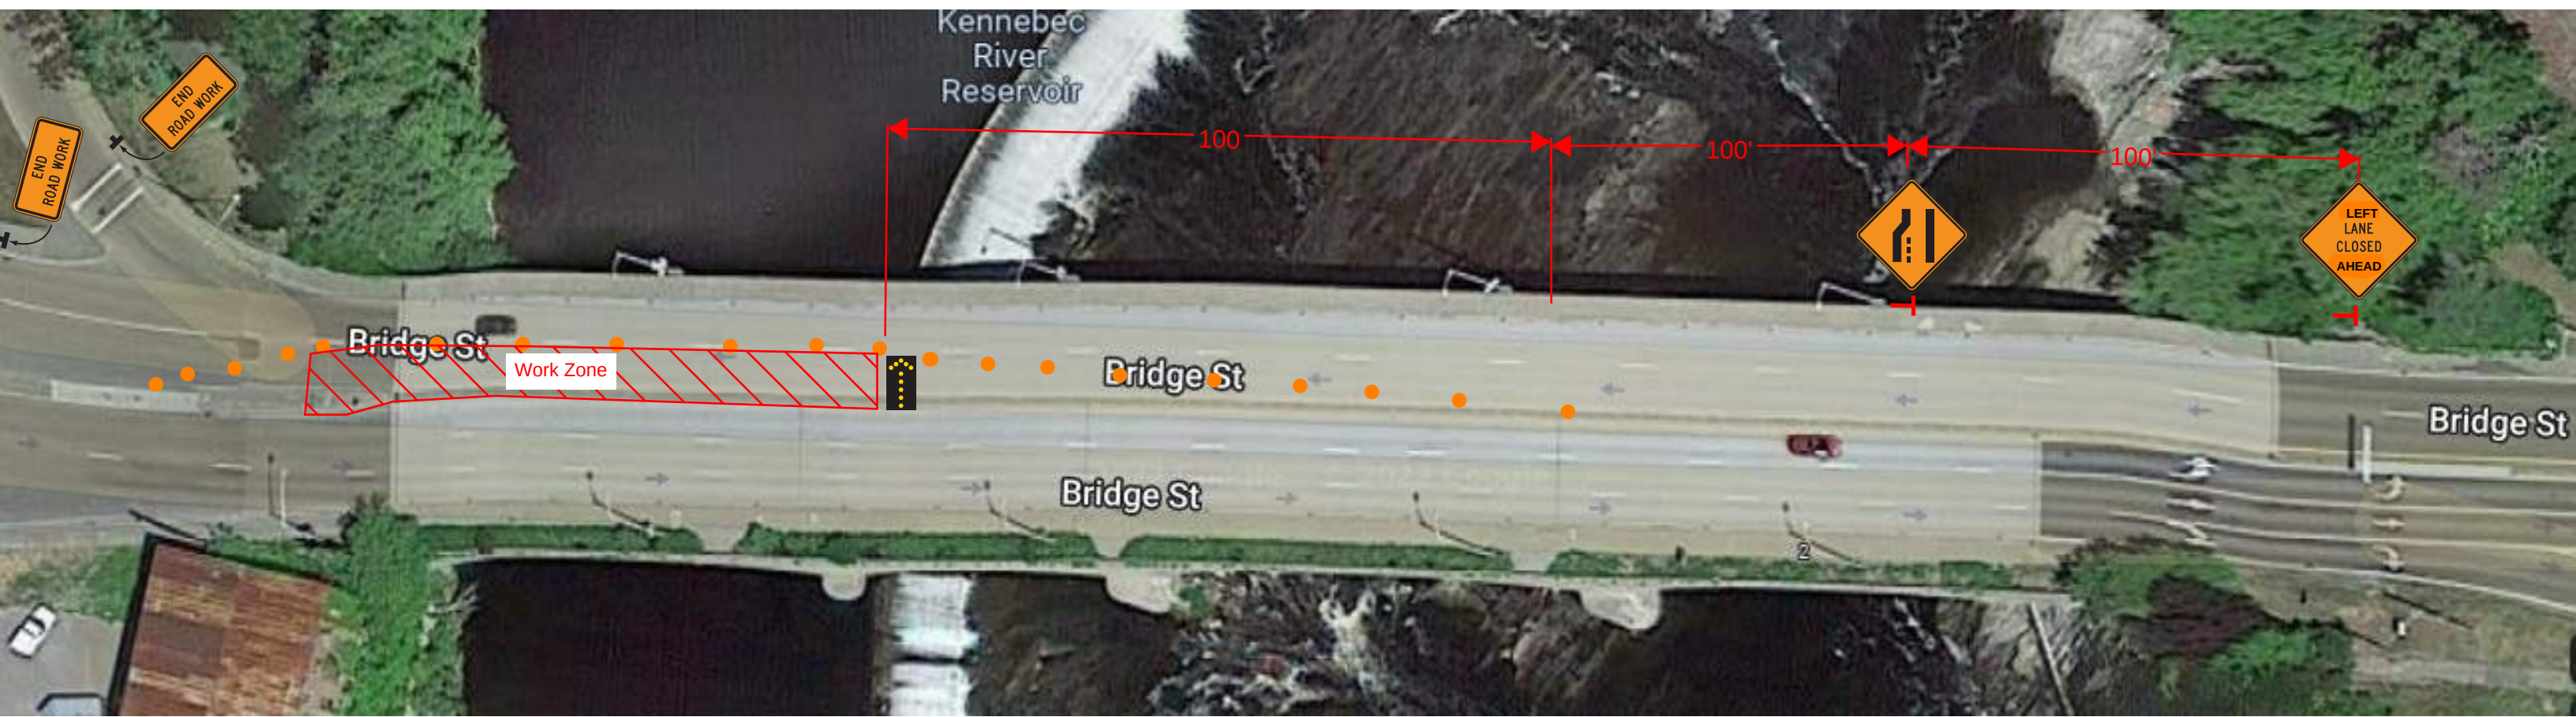

PLAN C-2

Notes:
1. All Advanced Warning Signs as shown in Standard detailed 652(12) are pre-installed.

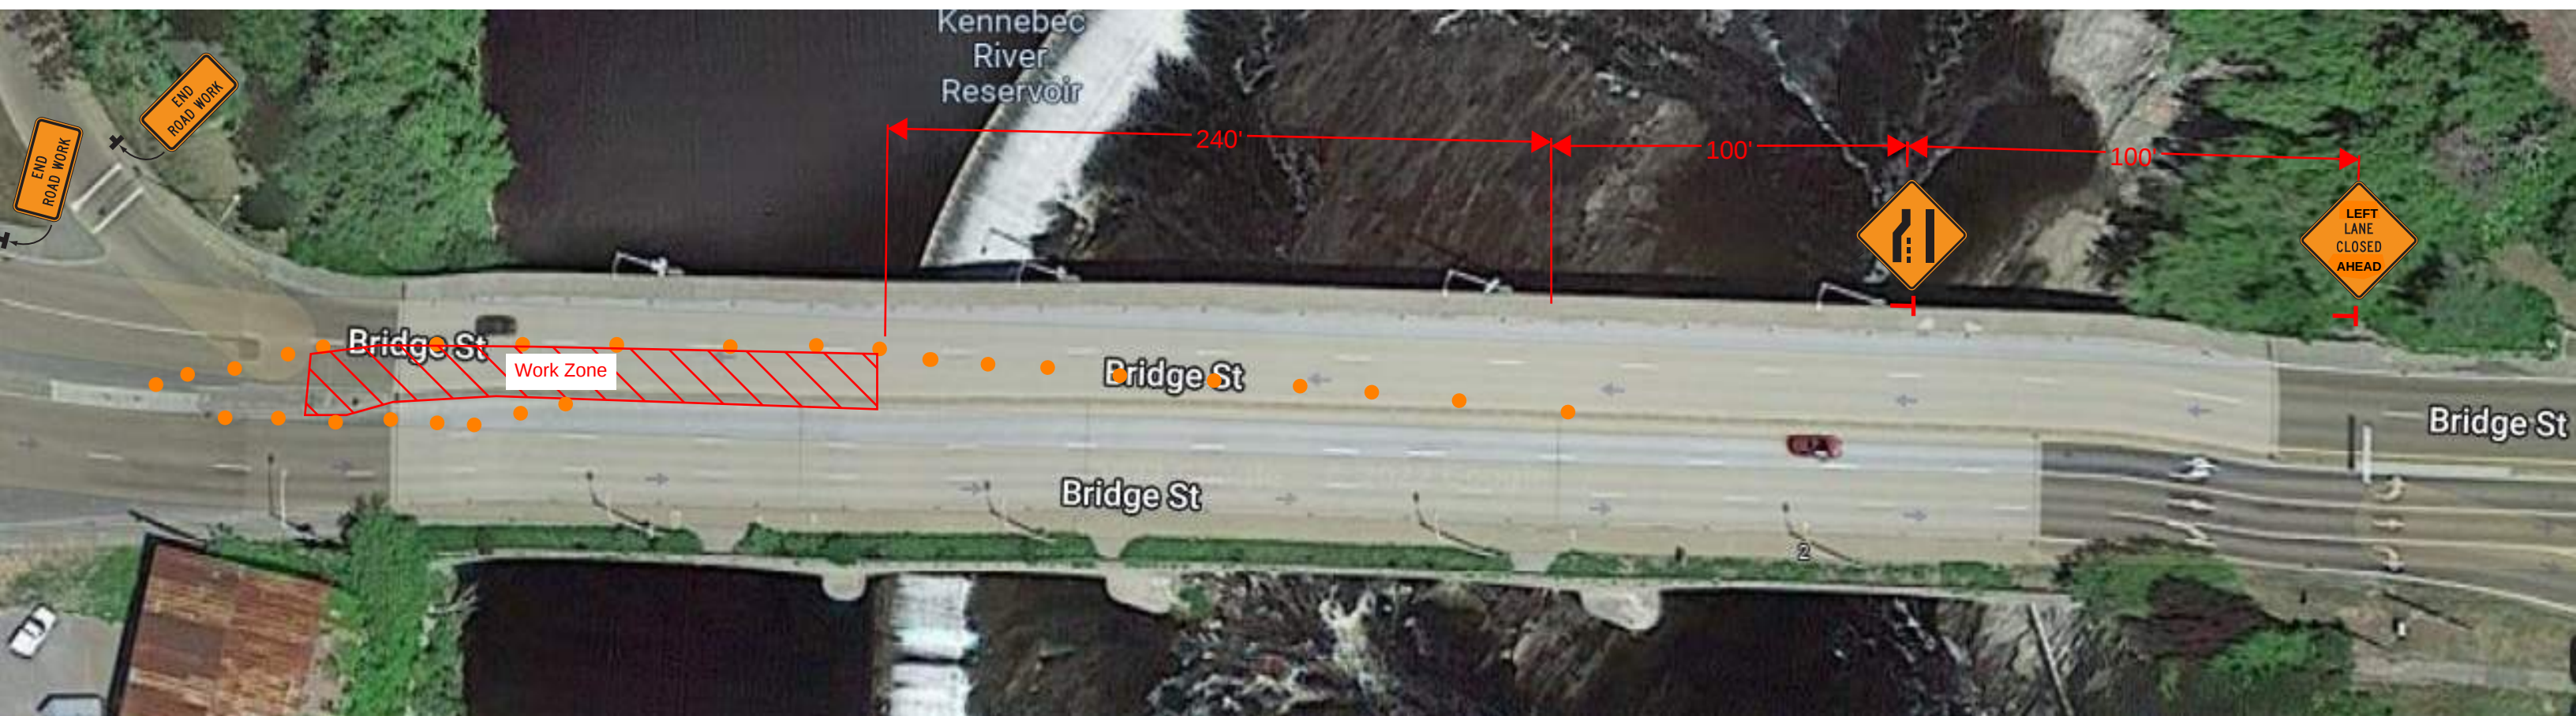

PLAN D



Notes:
1. All Advanced Warning Signs as shown in Standard detailed 652(12) are pre-installed.

PLAN D



Notes:

1. All Advanced Warning Signs as shown in Standard detailed 652(12) are pre-installed.
2. Right Lane Shown, Left Lane Similar



PLAN E

SILVER STREET

Waterville Area
Habitat for Humanity

Silver Street Tavern
& Restaurant

Cancun Mexican
bar and grill
Mexican • \$\$

Front & Main

Greene Block + Studios

Levine's Park

RIGHT
LANE
CLOSED
AHEAD

Notes:
1. All Advanced Warning Signs as
shown in Standard detailed 652(12)
are pre-installed.

Spring St

Kennebec St

Oxford St

Lockwood Alley


Kennebec St

Main St


137

Bridge St

Google

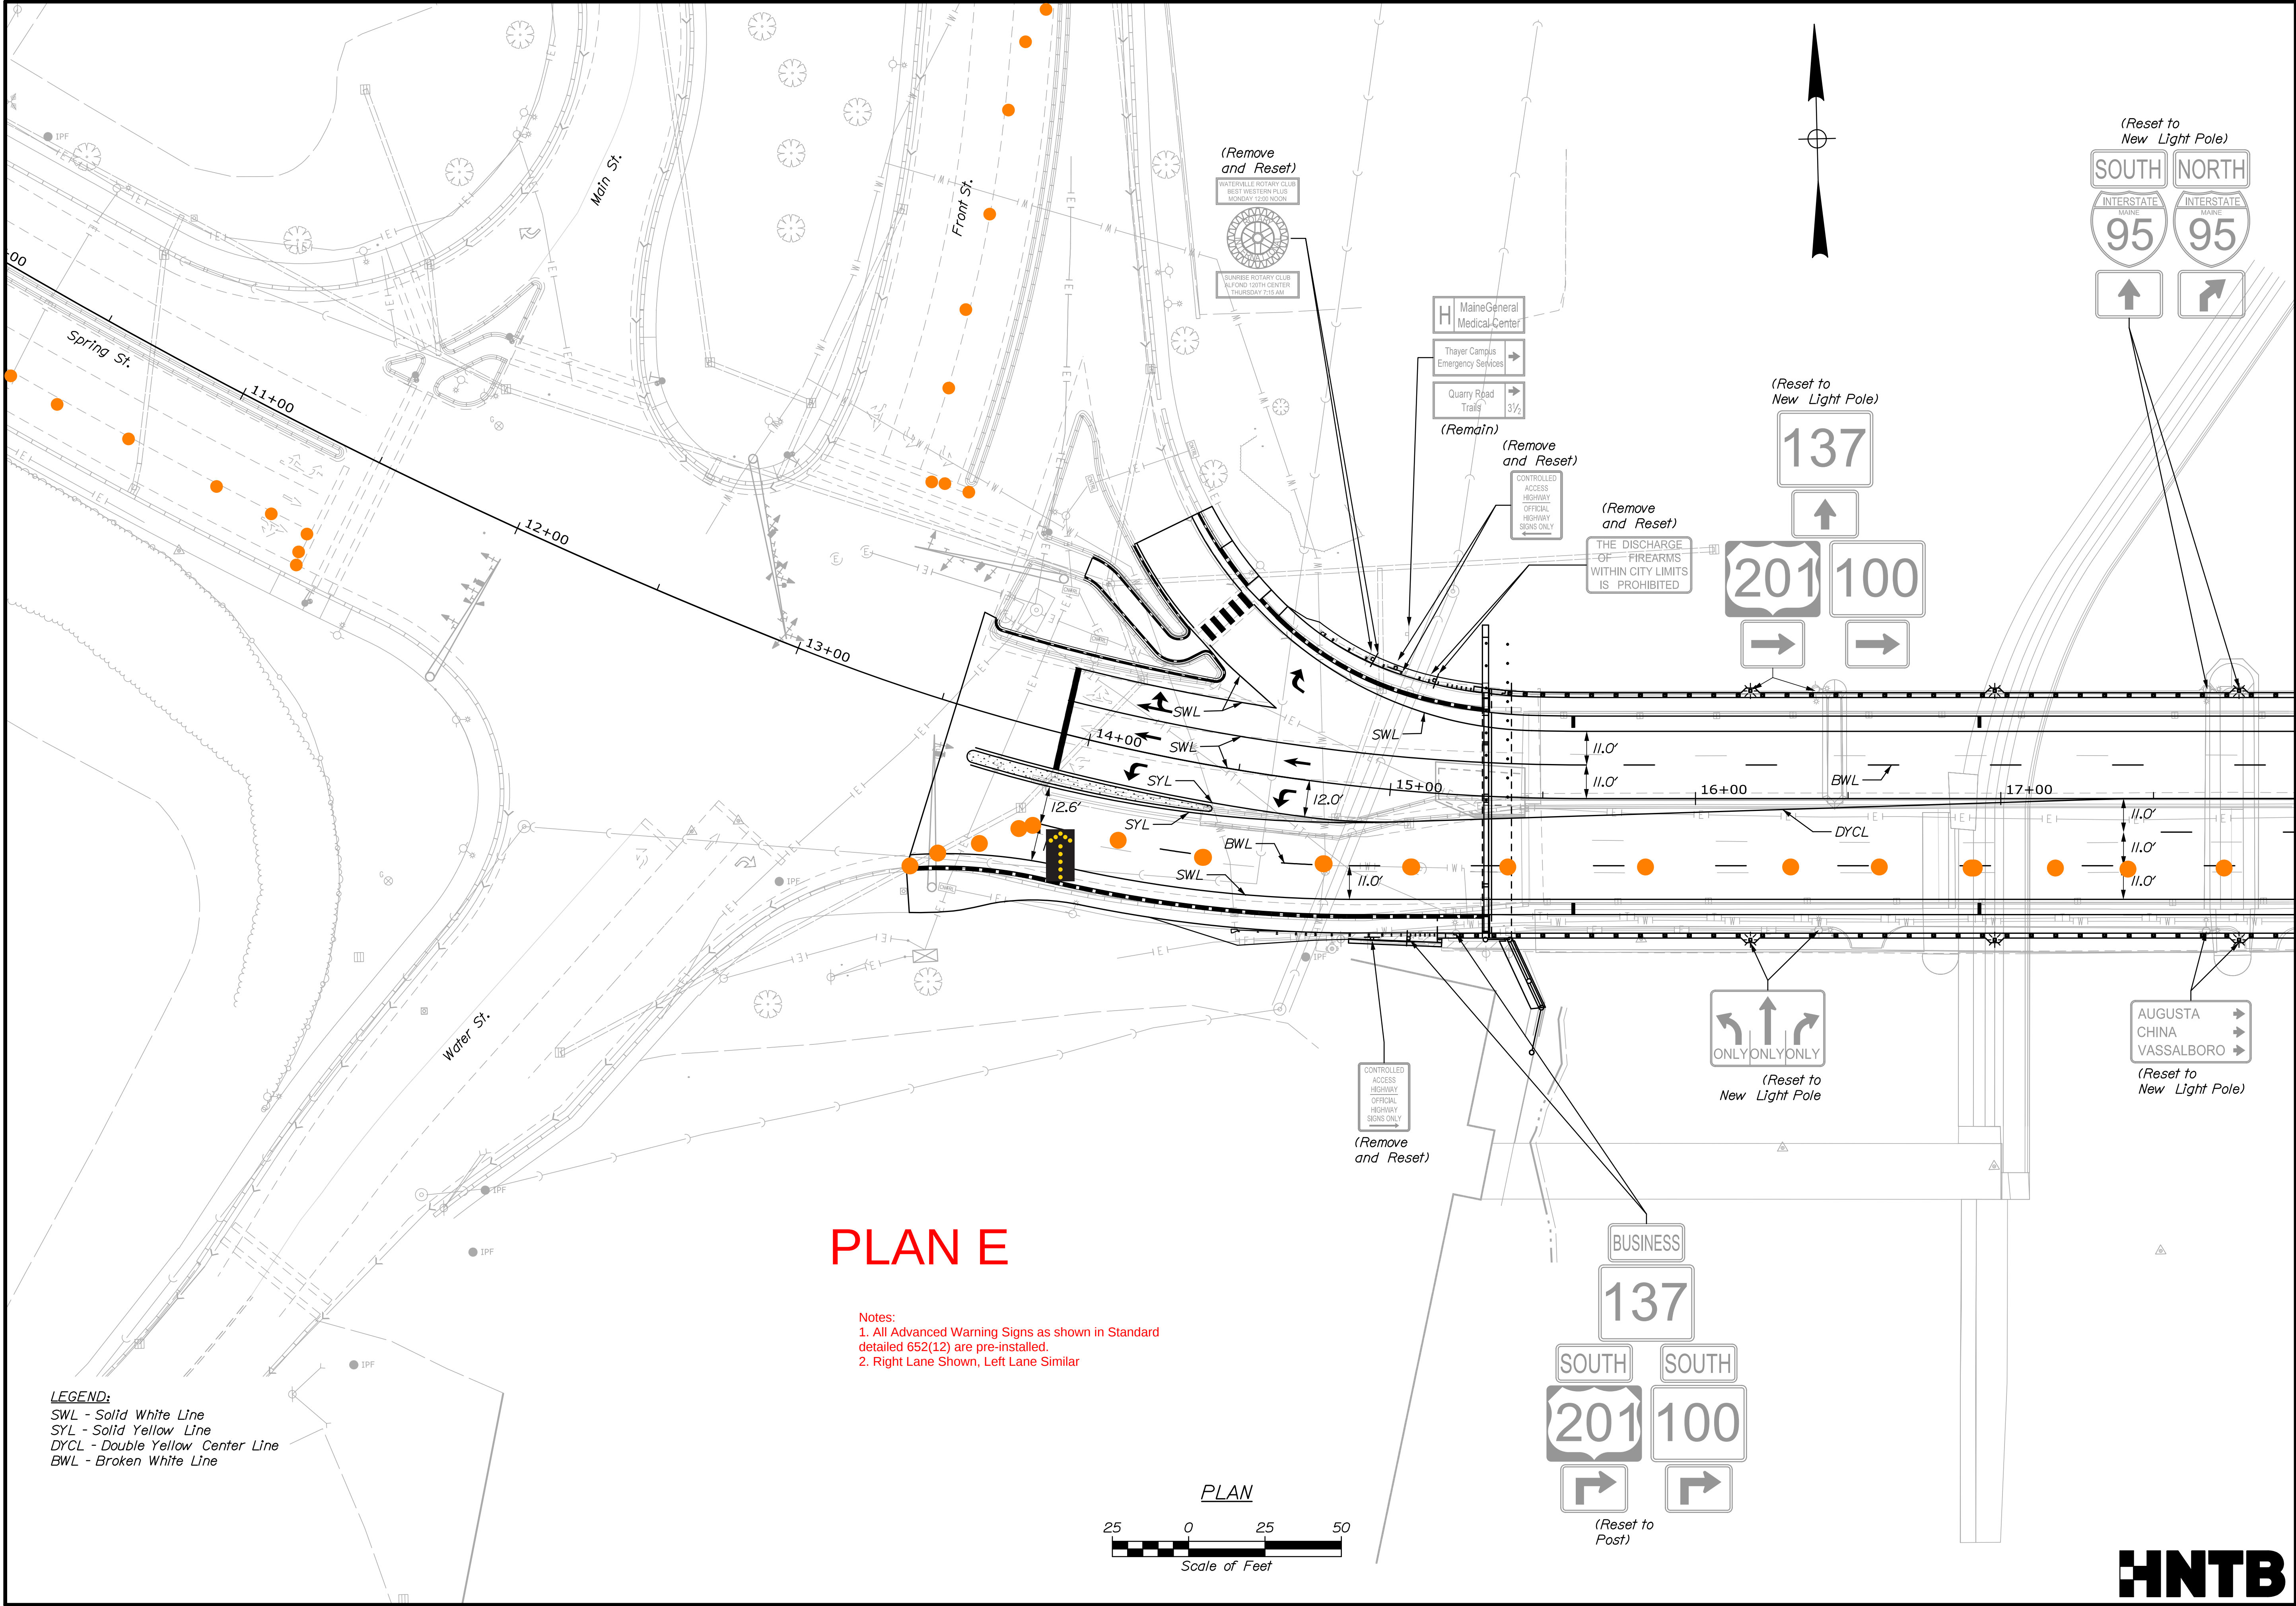

STATE OF MAINE		DEPARTMENT OF TRANSPORTATION		2313800		WIN		023138.00		BRIDGE PLANS	
TICONIC BRIDGE		KENNEBEC RIVER RESERVOIR		KENNEBEC		SIGNING & STRIPING		PLAN 1		SHEET NUMBER	
WATERVILLE-WINSLOW		DATE		SIGNATURE		P.E. NUMBER		DATE		20	
PROJ. MANAGER		BY		DATE		REVISIONS 1		REVISIONS 2		OF 111	
DESIGN-DETAILED		M. Parlin		6/2022		DESIGN-DETAILED		REVISIONS 3			
CHECKED-REVIEWED		C. Helmick		6/2022		DESIGN-DETAILED		REVISIONS 4			
DESIGN-DETAILED		L. Driscoll				REVISIONS 1		FIELD CHANGES			
DESIGN-DETAILED						REVISIONS 2					
DESIGN-DETAILED						REVISIONS 3					
DESIGN-DETAILED						REVISIONS 4					
DESIGN-DETAILED						FIELD CHANGES					

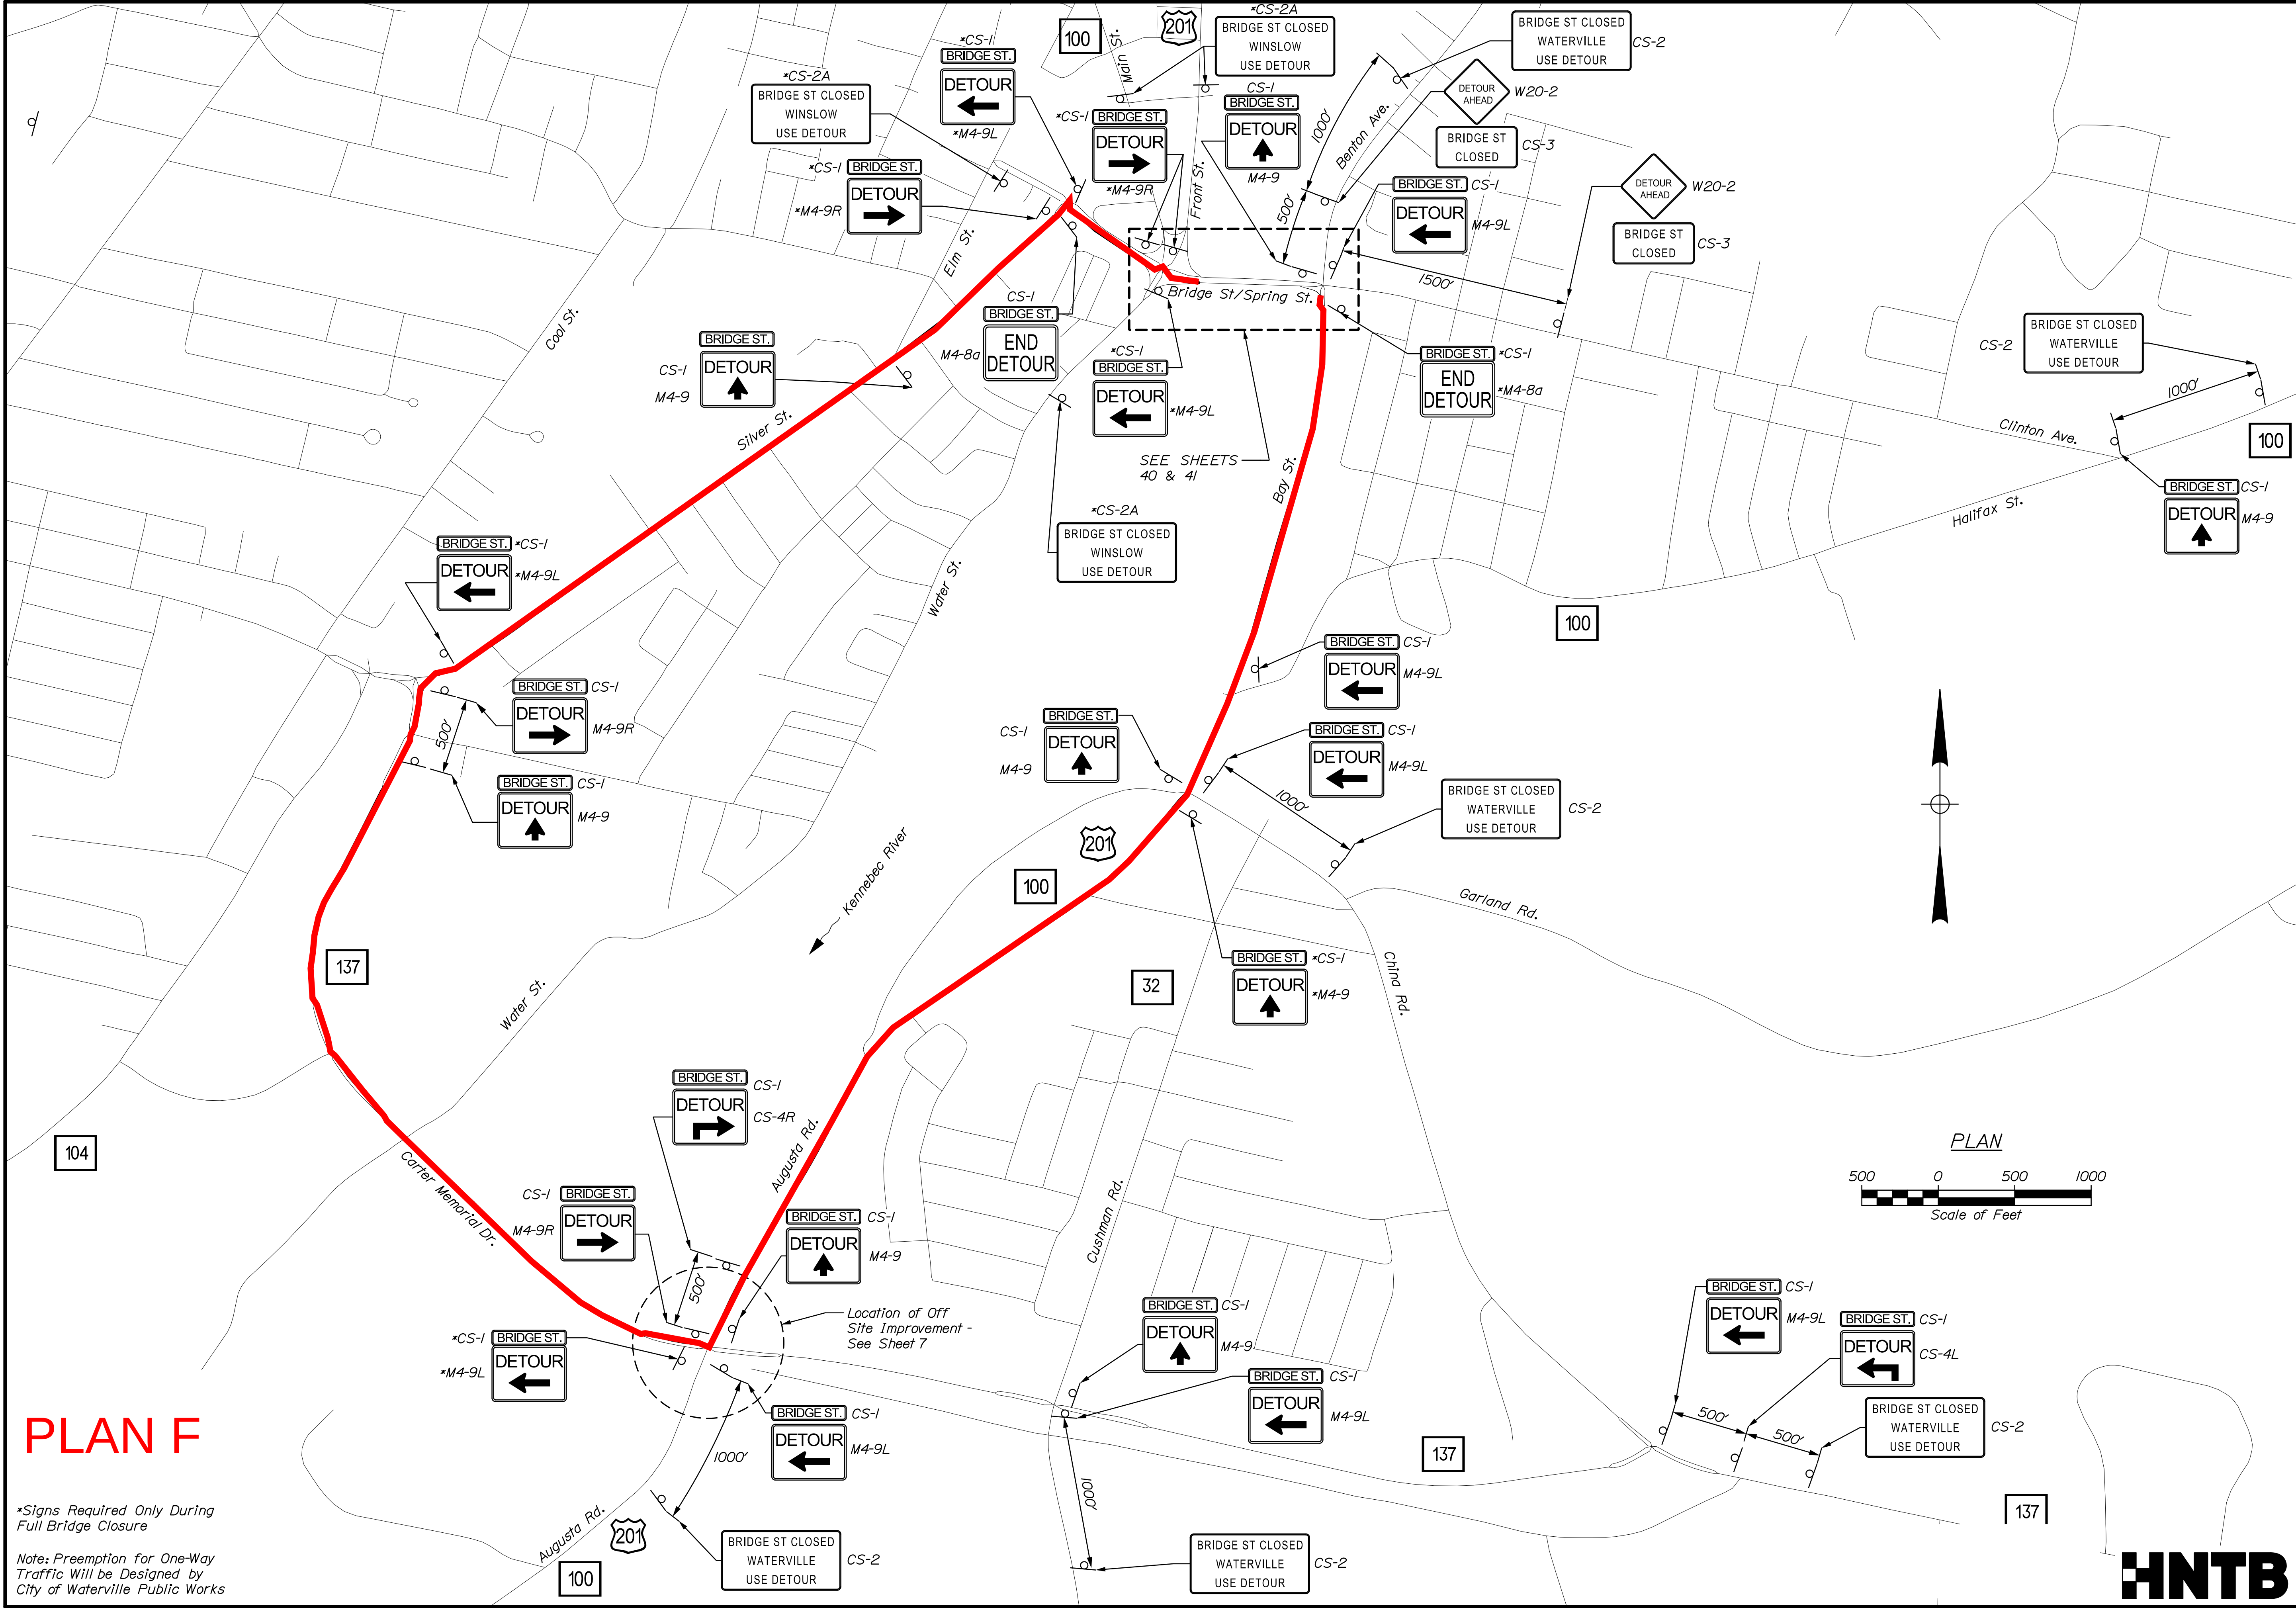

PLAN F

*Signs Required Only During Full Bridge Closure

Note: Preemption for One-Way Traffic Will be Designed by City of Waterville Public Works

STATE OF MAINE		DEPARTMENT OF TRANSPORTATION		2313800		WIN		023138.00		BRIDGE PLANS	
TICONIC BRIDGE		KENNEBEC RIVER RESERVOIR		KENNEBEC		DETOUR PLAN 1		WESTBOUND TRAFFIC DETOUR		SHEET NUMBER	
WATERVILLE-WINSLOW		DESIGNED-DATE		CHECKED-REVIEWED		DESIGNED-DATE		CHECKED-REVIEWED		37	
M. Parlin		C. Helmick		L. Driscoll		A. Stephens		SIGNATURE		OF 111	
DATE		6/2022		6/2022		6/2022		P.E. NUMBER		DATE	
REVISIONS 1		REVISIONS 2		REVISIONS 3		REVISIONS 4		FIELD CHANGES			

Filename: 038_Detour Plan_02.dgn

Date: 8/19/2022

Username:

Division:

PLAN G



PEDESTRIAN DETOUR NOTES:
1. Pedestrian detour shall only be in effect during certain times in Stage I as laid out in the Special Provisions. When detour is not in effect, the Type III Barricades shall be removed and pedestrian detour signs covered up.
2. Aerial imagery on the Waterville side does not reflect the final condition of the intersection and roadways as constructed under WIN 24371.
3. Locations of the Pedestrian Detour signs are approximate. Final locations of all signs shall be approved by the Resident.

PLAN



STATE OF MAINE		DEPARTMENT OF TRANSPORTATION		2313800		WIN		023138.00		BRIDGE No. 2854		BRIDGE PLANS	
TICONIC BRIDGE		KENNEBEC RIVER RESERVOIR		WATERVILLE-WINSLOW		KENNEBEC		DETOUR PLAN 2		PEDESTRIAN DETOUR		SHEET NUMBER	
PROJECT MANAGER		BY		DATE		SIGNATURE		P.E. NUMBER		DATE		38	
DESIGN-DETAILED		C. Helmick		6/2022								OF 111	
CHECKED-REVIEWED		L. Driscoll		6/2022									
DESIGN-DETAILED													
REVISIONS 1													
REVISIONS 2													
REVISIONS 3													
REVISIONS 4													
FIELD CHANGES													

